| GROUP | | PARTS LIST | | |
|---|---|---|---|---|
| 02 | 01 | ITEM | PART | DESCRIPTION |

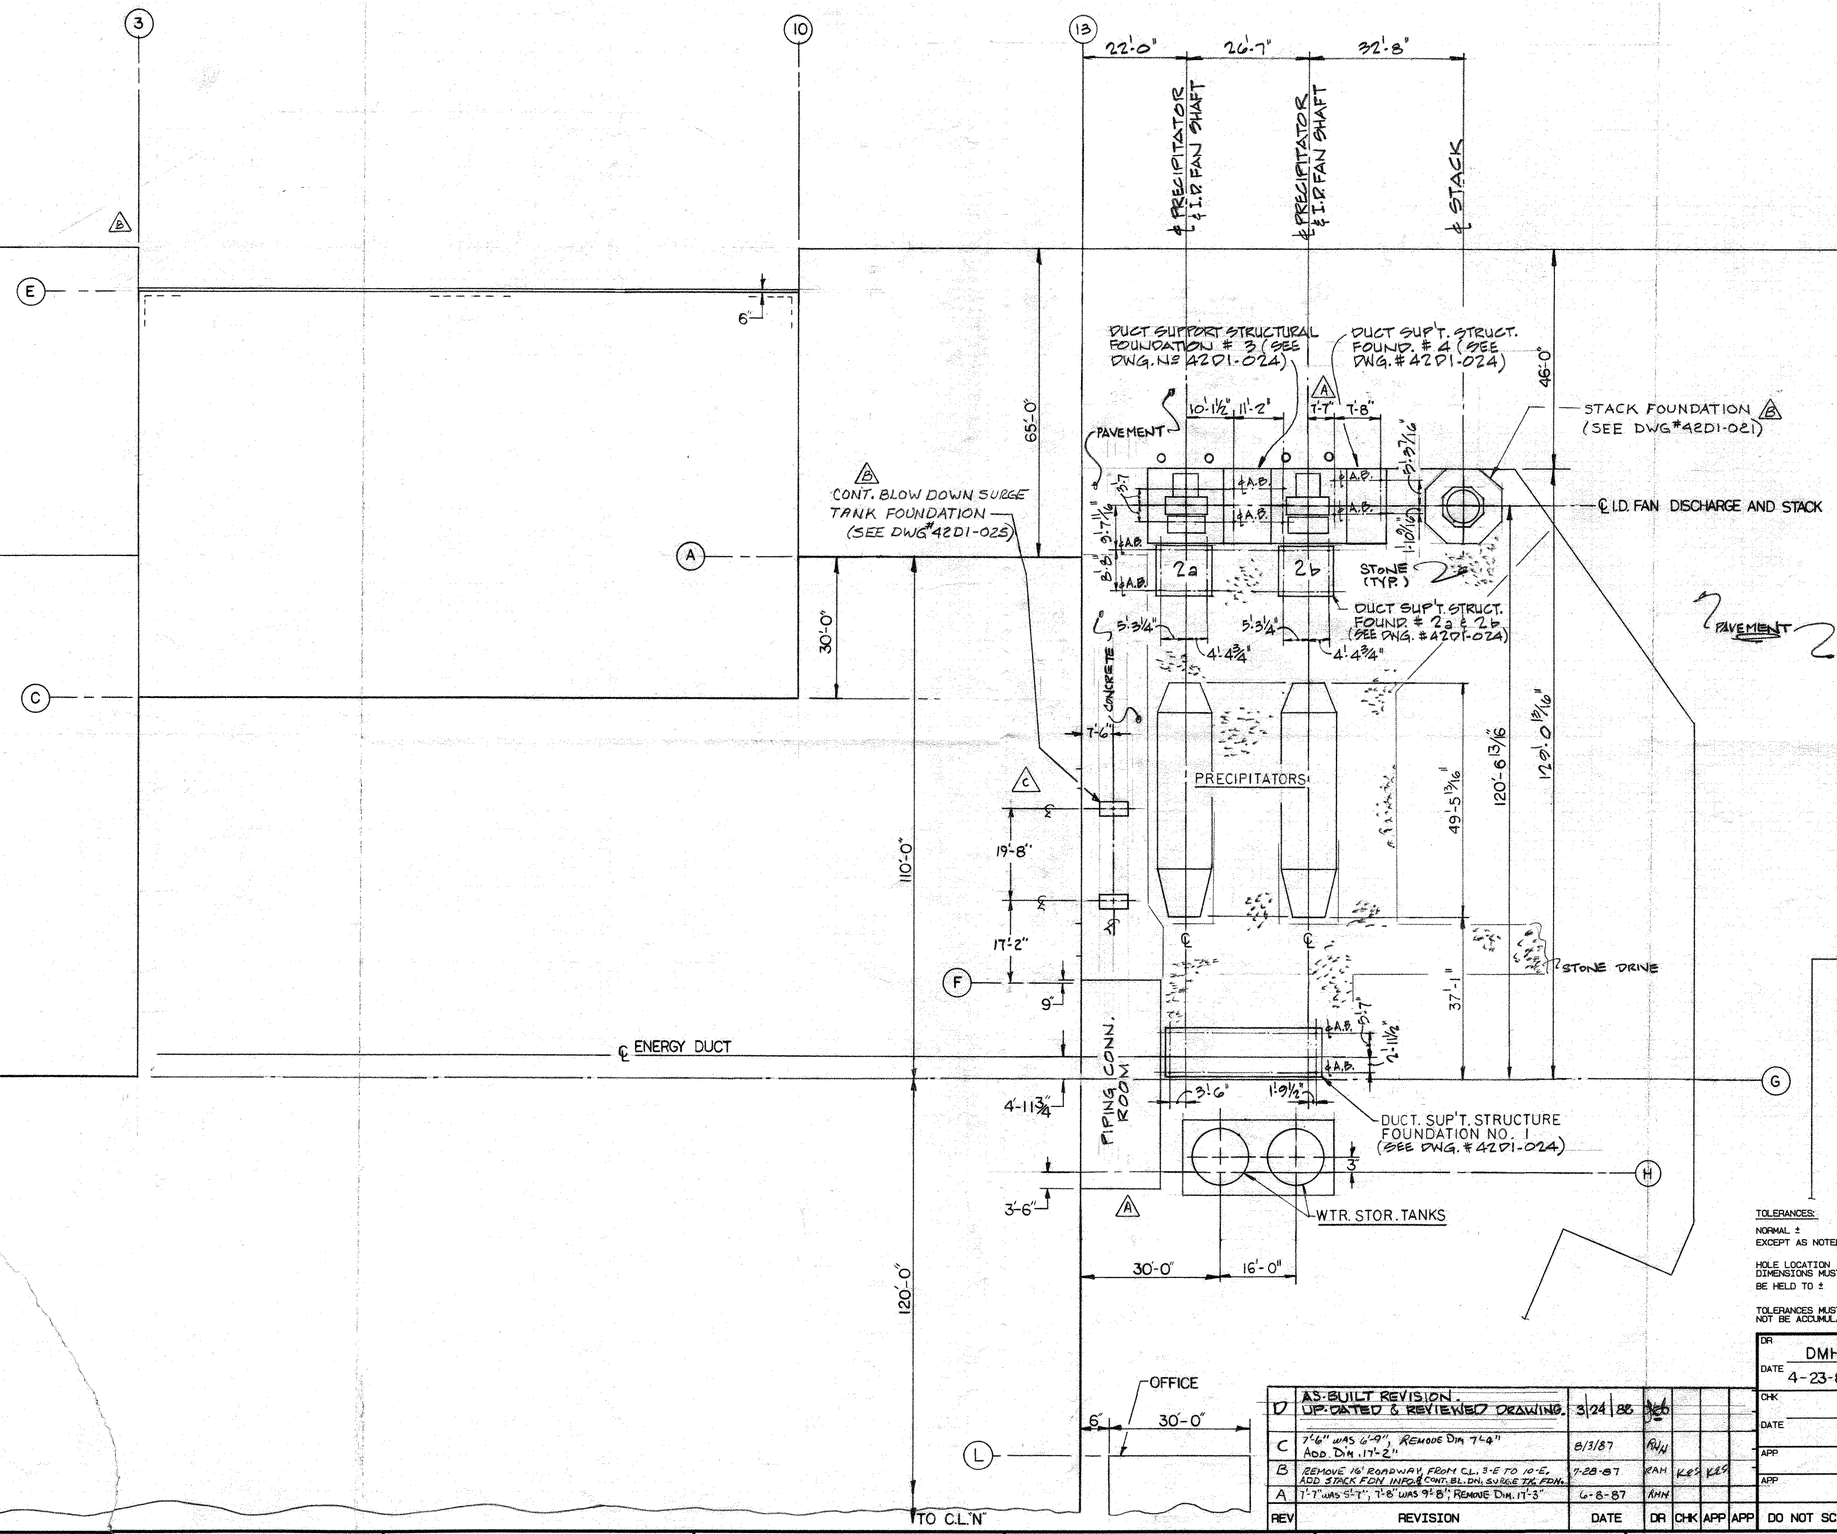


TOLERANCES:
NORMAL ±
EXCEPT AS NOTED.

HOLE LOCATION DIMENSIONS MUST BE HELD TO ±

TOLERANCES MUST NOT BE ACCUMULATIVE.

| REV | REVISION | DATE | DR | CHK | APP | APP |
|---|---|---|---|---|---|---|
| D | AS-BUILT REVISION. UPDATED & REVIEWED DRAWING. | 3/24/88 | JCB | | | |
| C | 7'-6" WAS 6'-9", REMOVE DIM 7'-4" ADD DIM. 17'-2" | 8/3/87 | RHH | | | |
| B | REMOVE 16' ROADWAY FROM C.L. 3-E TO 10-E. ADD STACK FDN. INFO & CONT. BL. DN. SURGE TK. FDN. | 7-28-87 | KAH | KRS | KRS | |
| A | 1'-7" WAS 2'-1", 7'-8" WAS 9'-8"; REMOVE DIM. 17'-3" | 6-8-87 | KHH | | | |

DO NOT SCALE

| | | | | | | |
|---|---|---|---|---|---|---|
| HARFORD | P4805 | | | | | |
| PROJ NAME | PROJ NO. | GRP. | B/M | D/L | NEXT HIGHER ASSY | |

THIS DRAWING IS THE PROPERTY OF CONSUMAT SYSTEMS INC. AND IS TO BE USED ONLY FOR PRODUCING ITEMS ON ORDER FOR CONSUMAT SYSTEMS INC. SUBJECT TO RETURN UPON DEMAND AND IS NOT TO BE PRINTED, PHOTOGRAPHED, COPIED, REPRODUCED, LOANED OR USED IN ANY WAY WITHOUT WRITTEN PERMISSION OF CONSUMAT SYSTEMS, INC.

DR DMH
DATE 4-23-87
CHK
DATE
APP
APP

**Consumat Systems, Inc.**
RICHMOND, VIRGINIA U.S.A.

TITLE
PLOT PLAN
DETAILS
HARFORD CO. RESOURCE RECOVERY FACILITY, MD.

SCALE 1/16"=1'-0"
REFERENCE

SIZE D
DWG NO. 7624-0000-41D2-010
SHEET 1 OF 1
REV D